






400L CARTAGE TANK SKID

for tank only


FFAR500.4041

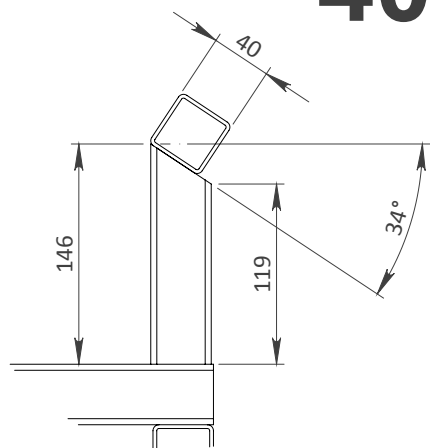

DETAIL A

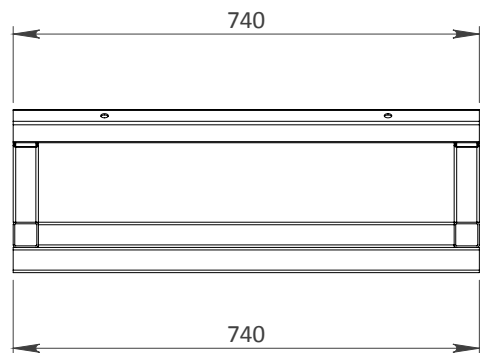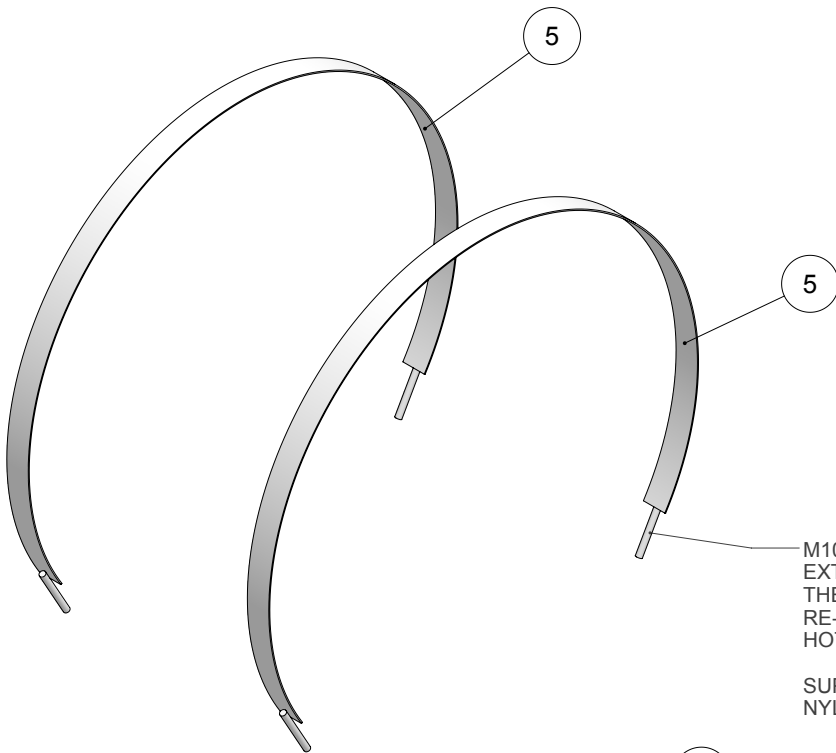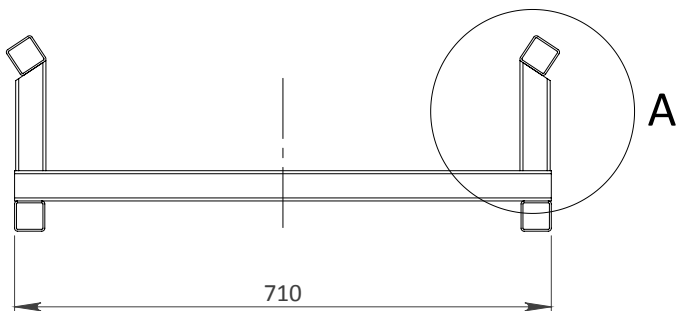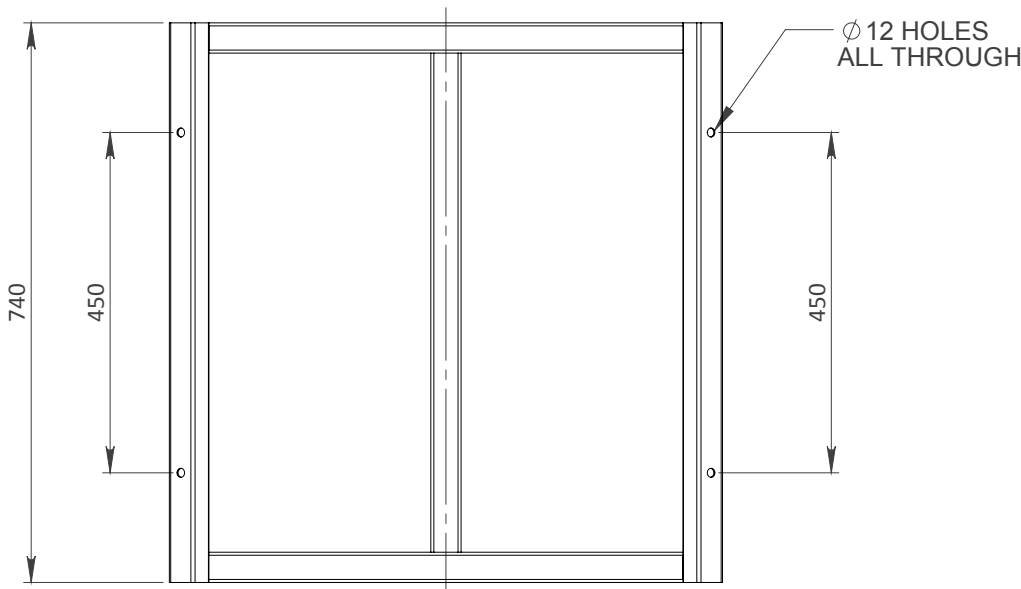

MARK.	DESCRIPTION	QTY.	LENGTH (mm)
1	40 x 40 x 2.5 SHS	2	710
2	40 x 40 x 2.5 SHS	4	146
3	40 x 40 x 2.5 SHS	4	740
4	40 x 40 x 2.5 SHS	1	660
5	40 x 3 FLAT	2	1715

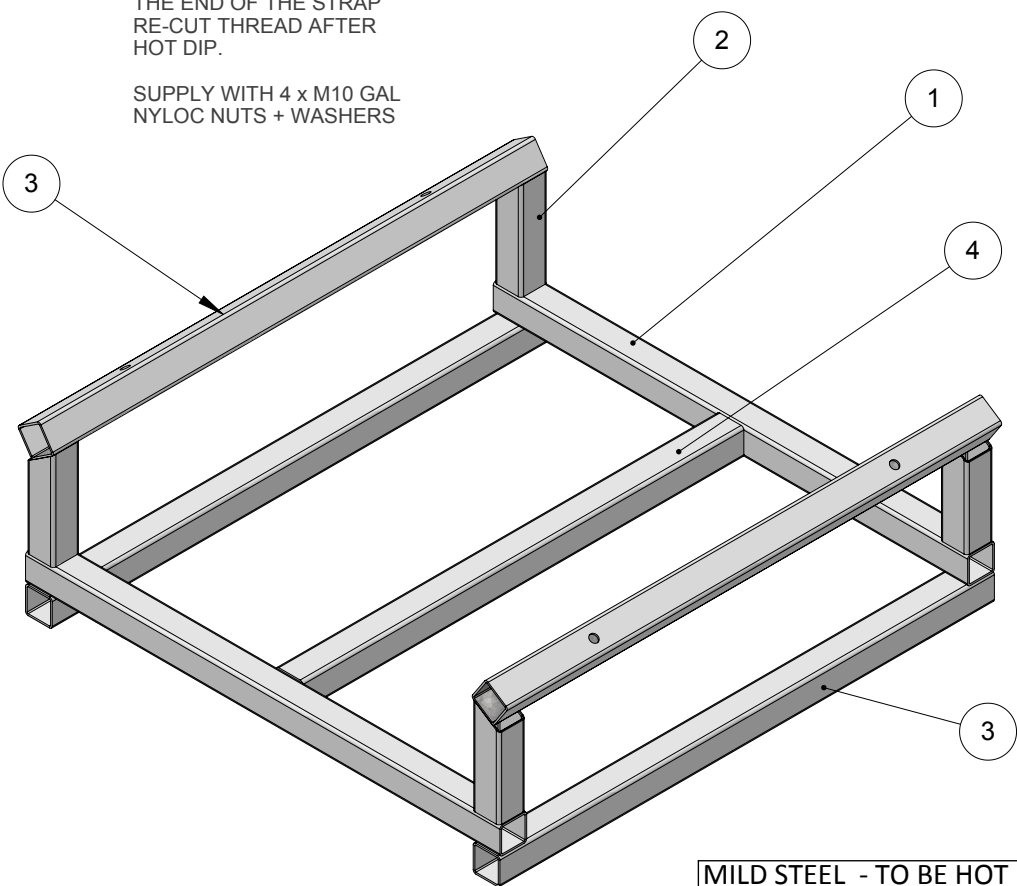

MILD STEEL - TO BE HOT DIP GALVANISED
*DRILL VENT/DRAIN HOLES ALL CORNERS
MIN. 8mm DIA.

WEIGHT APPROX: 24KG

REV	DATE	REVISION DESCRIPTION	DRAWN	CHKD	LEAD ENG
A	06.02.19	AS BUILT	DH	LS	

GOUGH
PLASTICS

A.C.N. 010 028 547
Gough Industries Pty. Ltd.
833 Ingham Road
Bohle, Townsville
P.O. Box 7570, Garbutt BC, Qld. 4814.
Telephone 07 47747606
Facsimile 07 47747608

CLIENT LOGO.

400L CARTAGE TANK STANDARD SKID

SCALE

NTS

A3

Gough Plastics Drg. No.

RUR-SKID-400-S

A

REV

S:\Sales\Rural\Sales & Marketing\Cartage tanks\400L Cartage tank